

**GENERAL NOTES**

1. OPENINGS FOR ROOM CENTERING OF STUD OR FACE OF STUD AS SHOWN ON THE RESTROOM PLAN. SEE SHEET A-21.
  2. EXTERIOR INSULATED WALLS PROTRUDE 1/2" BEYOND THE FOUNDATION WALL LINES.
  3. SEE WALL TYPE SCHEDULE FOR WALL FRAMING NOTES.
  4. INTERIOR WALLS AND CEILING AROUND VESTIBULE AND 1/4" TO BE INSULATED.
  5. PROVIDE SOUND BLOCING IN THE SLAB AT ALL GROSS STAIRS, CHANGEOVERS, TACKBOARDS, BULLETIN BOARDS, TOILET COMPARTMENTS, VANITY ACCESSORY LOCATIONS SEE C-100 THROUGH C-105.
1. FOR BASEMENTAL COURT HANDINGS SEE SHEET A-21.
  2. SEAL ALL ELECTRICAL AND MECHANICAL PENETRATIONS IN WALL ABOVE AND BELOW CEILING IN ROOMS 021, 023, 024 AND 025. SLABS SEE DETAIL D/A-21.
  3. FOR DETAILS OF CHANGEOVERS AND TACKBOARDS SEE SHEET A-21.
  4. NOT USED.
  5. PROVIDE BACKING TO SUPPORT SCREEN PROVIDED BY OWNER IN THIS ROOM. LOCATION TO BE DETERMINED.
  6. ANTIMONY BOX 3" FROM WEST WALL AND 4" ABOVE FINISH FLOOR TO CENTER.


**FLOOR PLAN**

SCALE 1/8" = 1'-0"

**WALL TYPES SCHEDULE**

MARK	DESCRIPTION
W-1	2x4 FRAMING AT W. O.C. - TYPICAL OF ALL WALLS UNLESS OTHERWISE NOTED
W-2	2x4 FRAMING AT W. O.C.
W-3	2x4 FRAMING AT W. O.C.
W-4	1 3/4" x 3 1/2" LAMINATED VENEER NUMBER AT W. O.C.
W-5	1 3/4" x 3 1/2" LAMINATED VENEER NUMBER AT W. O.C.
W-6	1 3/4" x 3 1/2" LAMINATED VENEER NUMBER AT W. O.C. (EXTERIOR WALL)
W-7	2x4 FRAMING AT W. O.C. (EXTERIOR WALL) TYPICAL
W-8	1 3/4" x 3 1/2" LAMINATED VENEER NUMBER AT W. O.C. (EXTERIOR WALL) TYPICAL
W-9	2x4 FRAMING AT W. O.C. WITH SHEATHING BOTH SIDES (INTERIOR WALL)

**INTERIOR WALL LEGEND**

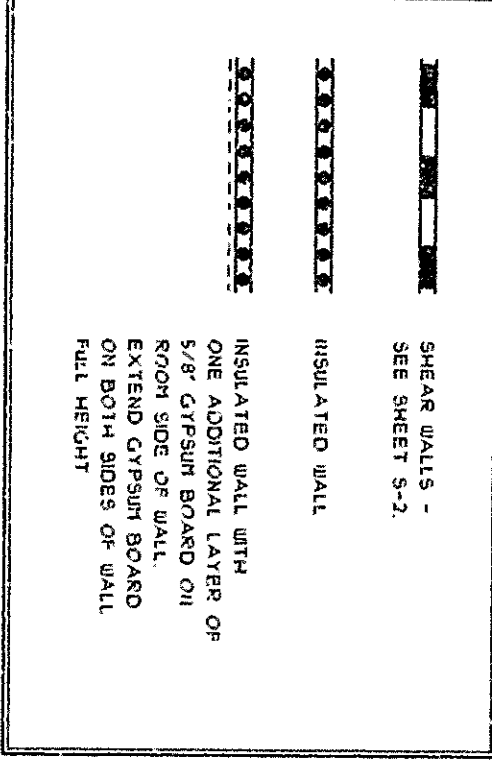

**MAIN FLOOR PLAN**


SPRINGVILLE 2, 4, 6 WARDS  
400 SOUTH 1800 EAST SPRINGVILLE, UTAH

**ASHWORTH & KNELL ARCHITECTS**  
JOE H. ASHWORTH, AIA, ARCHITECT LEE C. KNELL, AIA, ARCHITECT  
33 EAST 300 NORTH, SUITE 3, PROVO, UTAH 84604  
PHONE: (801) 373-8344 FAX: (801) 371-1078

REVISIONS
AS BUILT 10-1-94

DATE: 04-09-95

SHEET TITLE	PROJECT #
DRAWN BY	338-9486
CHECKED BY	PROFESSOR
	538-9489
	SHEET NUMBER
A-1	

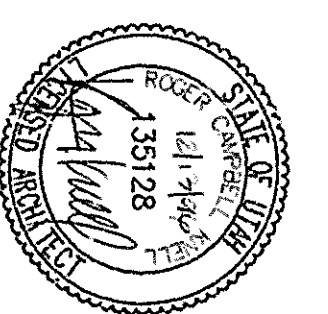

C:\WORK\PROJECTS\SPRINGVILLE 2, 4, 6 WARDS