

ADDENDUM

Project: Hobble Creek 1, 2, 3 Chapel HVAC

Project No.: 505-0871-18020101

Addendum No.: Two

Project Address: 555 South Averett Avenue, Springville, UT

Date: February 5, 2018

Owner: Corporation of the Presiding Bishop of The Church of Jesus Christ
of Latter-day Saints, a Utah corporation sole

From (Architect): John Alexander - Van Boerum & Frank Associates

Instructions to Prospective Bidders:

This Addendum forms a part of the Contract Documents and modifies the original Bidding Documents and/or prior Addenda as noted below. All conditions, requirements, materials and workmanship are to be as described in the Contract Documents unless specifically stated otherwise. This Addendum consists of two page(s) and the attached drawing(s), Sheet(s) EG601, EP101, & EP102, dated Feb. 5, 2018

1. Changes to prior Addenda:
 - a. None
2. Changes to Bidding Requirements:
 - a. None
3. Changes to Conditions of the Contract:
 - a. None
4. Changes to Specifications:
 - a. None
5. Changes to Drawings:
 - a. Refer to Sheet **M101**.
 - 1) Mechanical Room Plan 1/M101: Provide portable fire extinguisher with heavy duty mounting bracket on wall in mechanical room.
 - a) Fire Extinguisher:
 1. Ten pound dry chemical ABC stored pressurized type equipped with pressure gauge and which does not need recharging except after use.
 2. Instructions for repairs, maintenance, and recharging shall be attached.
 3. Unit shall be tested and approved by UL and have minimum 4A:60-B:C UL rating. UL rating shall appear on extinguisher labels and be attached to and a part of fire extinguisher units.
 4. Manufacturers: Amerex, Ansul Inc., Buckeye Fire Equipment.
 - b. Refer to Sheet **D1.1**.
 - 1) Provide 100 lineal feet of 6-foot-high chain link fence with lockable gate for temporary construction fence. Locate as directed by Owner to enclose construction area.
 - c. Refer to Sheet **G1.2**.
 - 1) Refer to Detail A and make the following changes:
 - a) Change the height of the brick and CMU mechanical enclosure wall to 4 feet above the concrete foundation. Make this change on all drawings.
 - b) Change the size of the gravel sump at the bottom of the stairs to 3'-0" diameter x 3'-0" deep gravel sump with filter fabric around gravel.
 - 2) Refer to Details E and F and make the following changes:
 - a) Change the metal angle frame at the inside and outside of the wall at the door to be L6 x 6 x 5/16. There will be a gap between angles. This will not need to be welded.
 - b) Increase the overall width of the hollow metal door frame to 8". Locate the frame to cover the gap at the metal angles.
 - 3) Refer to Detail G. Change the spacing of the rebar in the 10-inch wall to #4 bars at 12" O.C. each way. Make this change at all 10-inch-wide concrete foundations.
 - 4) Refer to Detail H. Add the following note: Contractor to step all footings so that all footings bear a minimum of 30 inches below finish grade.
 - d. Refer to attached Sheet **EG601**.
 - 1) Updated Panel Schedule CHB. Changed from Main Lugs to Main Breaker and added spares and circuit for thermostats.

- e. Refer to attached Sheet **EP101**.
 - 1) Added light switch by new exterior door. Modified Keyed Note 3. Added Keyed Note 6. Modified General Note H.
- f. Refer to attached Sheet **EP102**.
 - 1) Added circuits for thermostat j-boxes. Modified General Note H.

6. Response to Questions:

- a. *Question 1: On drawing EP102 there are 3 junction boxes shown in the crawl space that show needing 120 volt power for 3 thermostats. Where will these circuits come from? Can we just find the closest panel to the area? Do they need to be dedicated circuits?*

Response: Circuit thermostat j-boxes to CHB-12 as indicated on revised drawings.

- b. *Question 2: With the change in the door location to enter the mechanical room do we need to add an additional switch so that the lighting can be turned on as you walk in that door?*

Response: 3-way light switch added by new exterior door on revised drawings.

- c. *Question 3: On drawing EP102 the location of the disconnects for the condensing units as shown. Can we run Seal tight conduit with the HVAC line sets straight from the disconnects to the units? if we do I believe we will be over the 6' maximum requirement for flexible conduit.*

Response: Sealtight conduit to be restricted to 6' maximum length. The contractor may run rigid conduit then transition to sealtight if needed to limit sealtight to required lengths or the contractor may locate the disconnects closer to the equipment to an Owner approved location that meets NEC clearance requirements.


- d. *Question 4: Can we use the existing wire from the 200 amp disconnect to power panel CHB?*

Response: The contractor will need to run new wire as indicated on revised drawings.

- e. *Question 5: Can we refeed the existing 60 amp 3 phase disconnect by installing new junction box in place of disconnect or will we need to run new wiring all the way back to source?*


Response: The preference is to keep the wall uncluttered. Locate the panel closer to the existing 60A disconnect if needed to eliminate the need for j-boxes to extend existing conductors.

End of Addendum

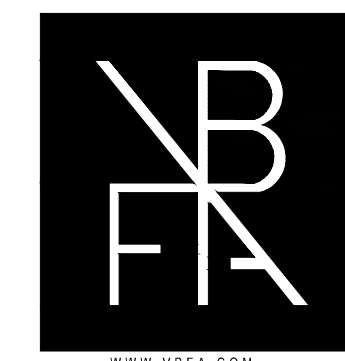

VAN BOERUM & FRANK ASSOCIATES, INC. CONSULTING ENGINEERS

330 South 300 East Salt Lake City, UT 84111 801.530.3148 T 801.530.3150 F

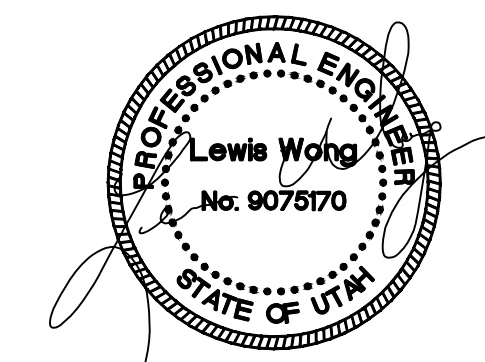

Original drawings remain the property of the Engineer and as such the Engineer retains total ownership and control. The design represented by these drawings are sold to the client for a one time use, unless otherwise agreed upon in writing by the Engineer. Van Boerum & Frank Assoc., 2014

Hobble Creek 1, 3, 13 & Springville UT Hobbie Creek Stk. SALT LAKE CITY, UTAH

Table with 2 columns: REVISIONS, DATE. Row 1: 2/5/2018, ADDENDUM #2. Row 2: 17329, 17329. Row 3: EW, EW. Row 4: JAN 2018, JAN 2018.

SHEET CONTENTS ELECTRICAL SCHEDULES

EG601

EQUIPMENT SCHEDULE table with columns: TYPE, DESCRIPTION, V/PH, LOAD, FLA, WIRE (SETS, QTY, SIZE, GND), COND, OCPD/MOCP, TYPE, DISC SIZE/PL, FUSE SIZE, STR, NEMA SIZE, REMARKS. Includes abbreviations and remarks sections.



EXISTING 200 AMP FUSED DISCONNECT TO BE REPLACED WITH PANELBOARD

EXISTING FUSED DISCONNECT AND CUTTER TO BE REMOVED

1 PHOTO ELEVATION OF DISCONNECT BANK NO SCALE

Table with columns: CHB, PANEL, VOLTAGE, MOUNTING, FEED, MAINS, DIMS, SPECIAL EQUIPMENT. Includes a detailed circuit schedule table with columns for circuit number, description, code, breaker, wire size, circuit load, combined phases, circuit load, wire size, breaker, code, circuit description, and circuit number.

THIS PANEL, ALL OF ITS LUGS, BREAKERS, ETC. SHALL BE RATED FOR 75° C

D

C

B



A

D

C

B

A

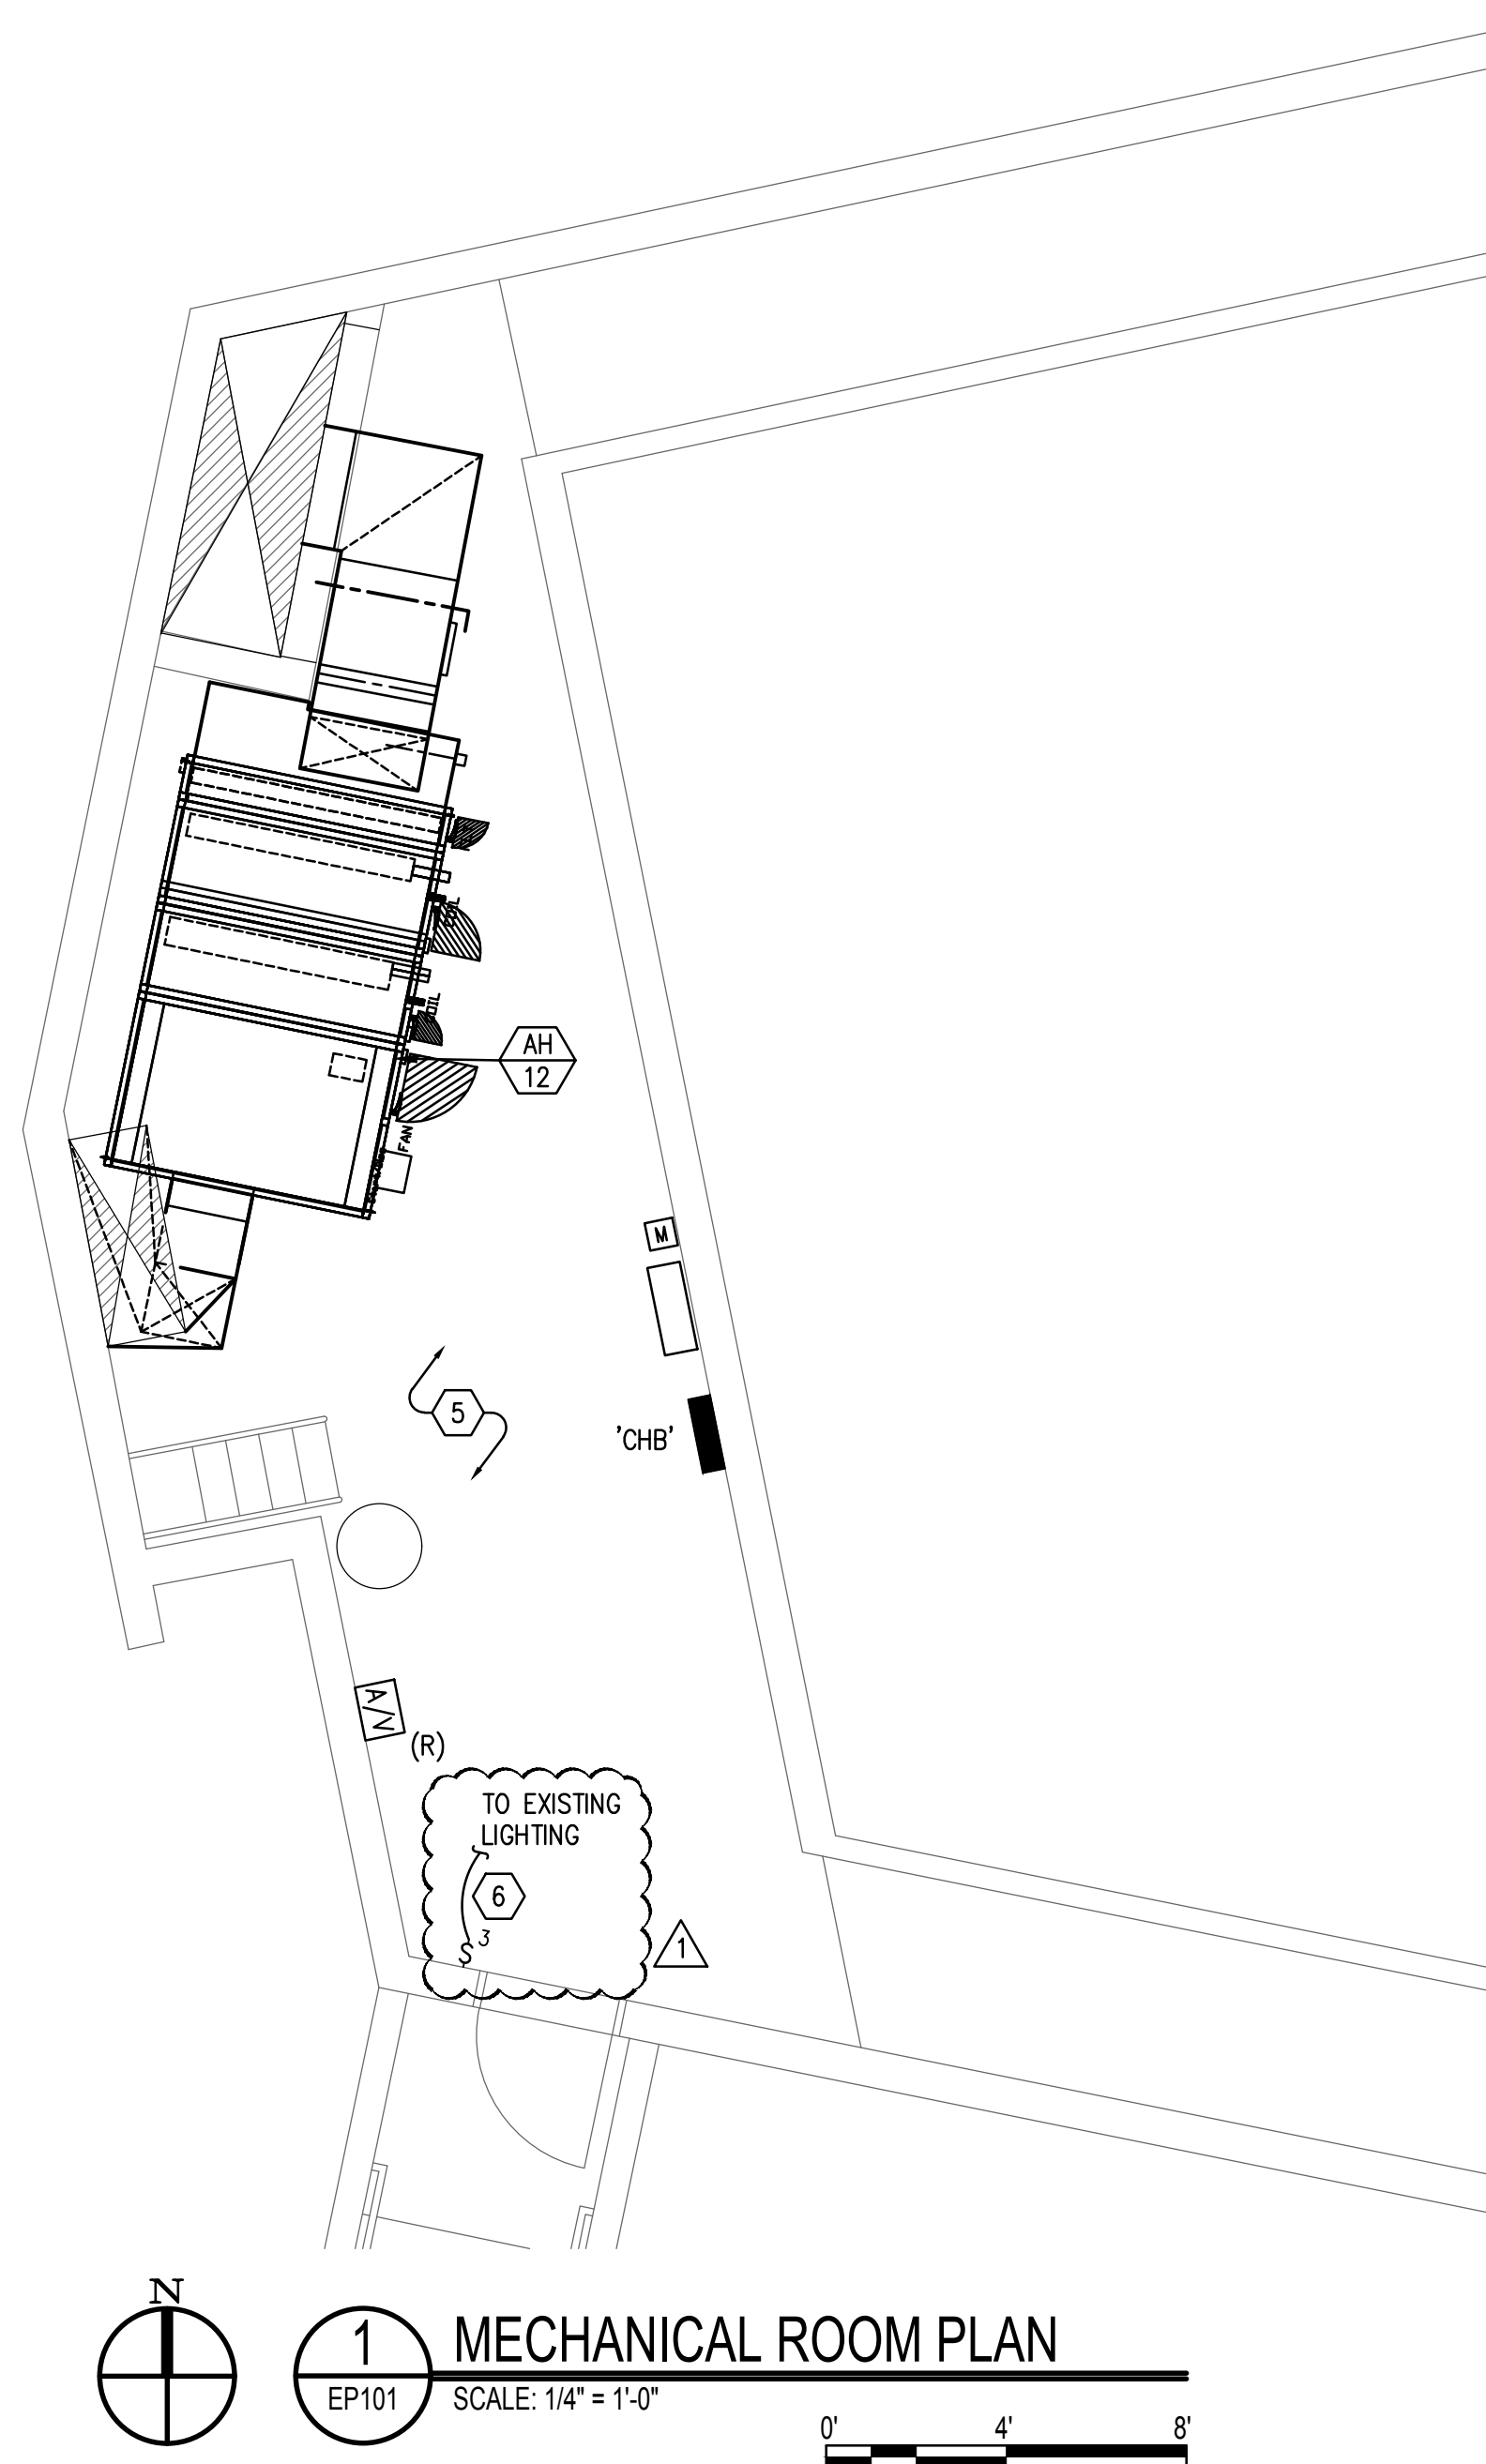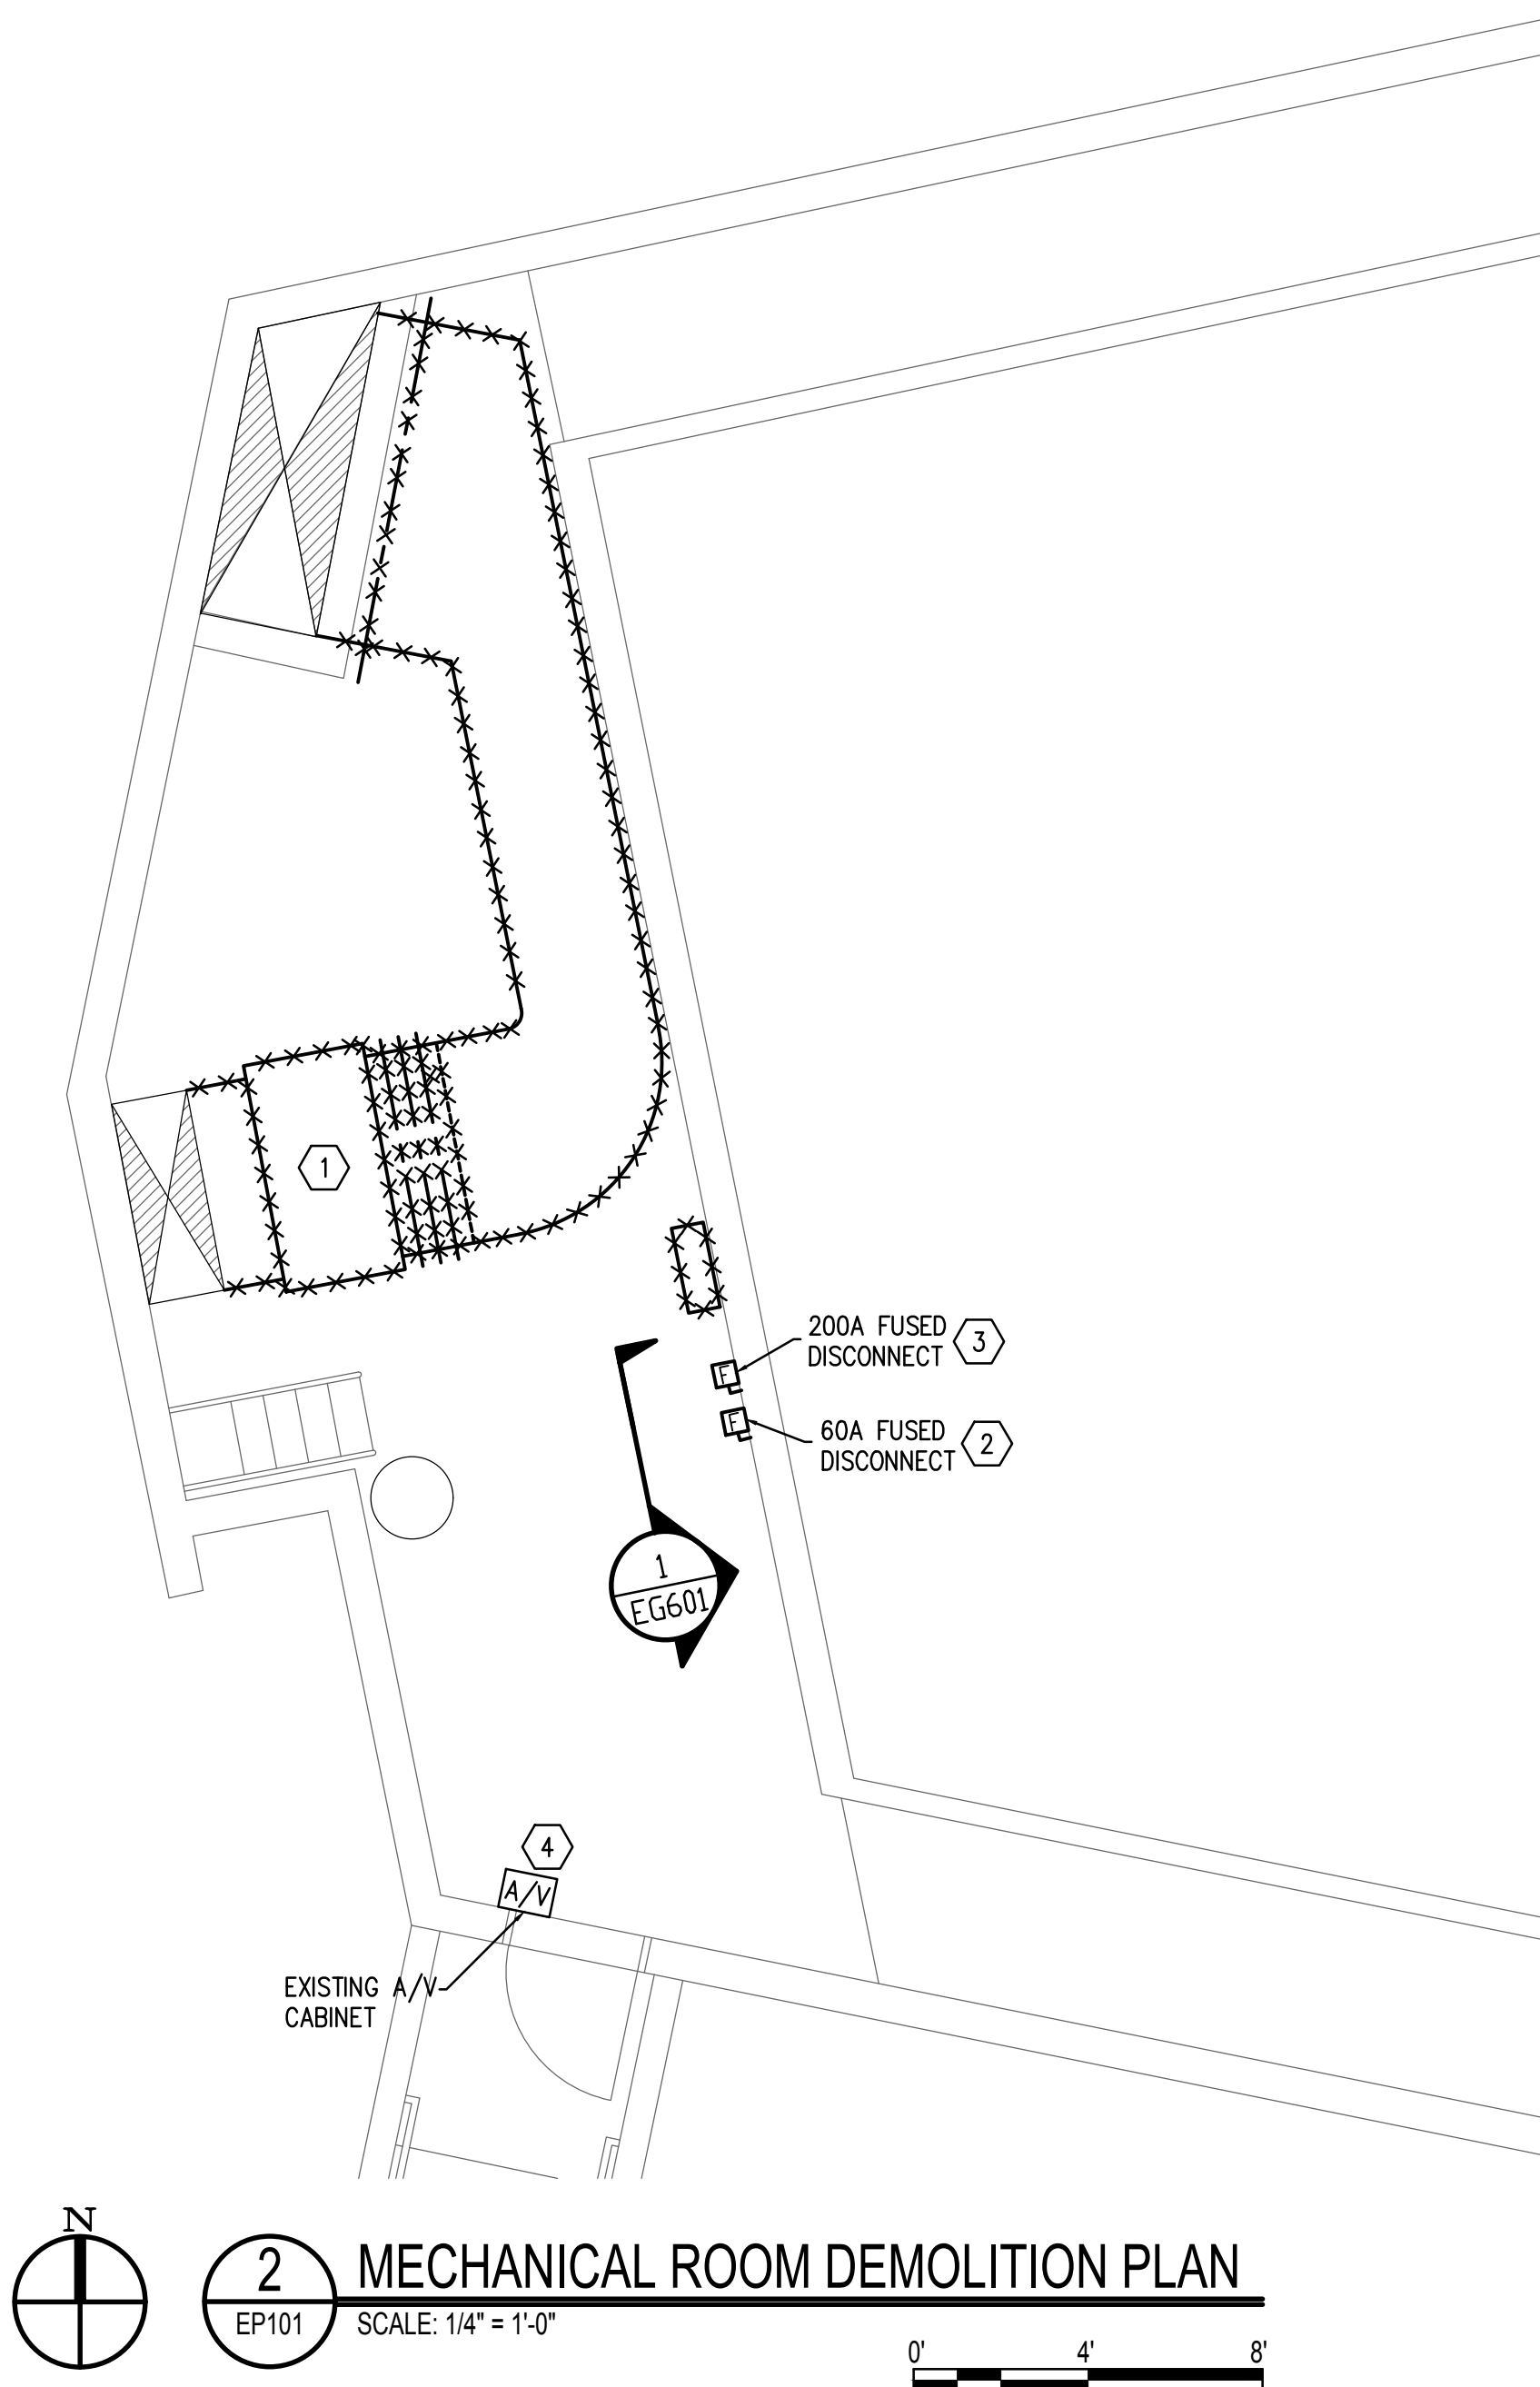

KEYED NOTES

- EXISTING MECHANICAL EQUIPMENT TO BE REMOVED. REMOVE CONDUIT, WIRE, AND ASSOCIATED DISCONNECTS BACK TO NEAREST REMAINING DEVICE/EQUIPMENT. MAINTAIN CIRCUIT INTEGRITY. IF NO DEVICES OR EQUIPMENT REMAIN, REMOVE CONDUIT AND WIRE BACK TO SOURCE AND MARK BREAKER AS SPARE. PROVIDE NEW UPDATED TYPED PANEL SCHEDULE INDEX. IF CONDUIT IS INACCESSIBLE, CUT CONDUIT FLUSH WITH STRUCTURAL SURFACE.
- REFEED EXISTING CIRCUITS FED FROM DISCONNECT TO NEW PANEL 'CHB'. REMOVE EXISTING DISCONNECT AND CUTTER RACEWAY AND EXTEND CONDUIT AND CONDUCTORS TO NEW PANEL.
- EXISTING DISCONNECT FEEDING THE EXISTING AIR HANDLER TO BE REMOVED AND REPLACED WITH NEW 200 AMP PANELBOARD 'CHB'. RUN (4) #5/0, (1) #6 FEEDERS FOR NEW PANEL IN EXISTING 2" C. REMOVE DOWNSTREAM CUTTER AND EXTEND EXISTING CONDUIT AND CONDUCTORS TO NEW PANEL. LAND EACH CIRCUIT ON A DEDICATED BREAKER. TRACE CIRCUITS AND PROVIDE BREAKER SIZE AS REQUIRED FOR EACH CIRCUIT. LOCATE NEW PANEL AS REQUIRED TO AVOID INSTALLING NEW J-BOXES TO EXTEND EXISTING CIRCUITS.
- RELOCATE EXISTING A/V CABINET TO NEW LOCATION SHOWN. EXTEND CONDUIT AND CONDUCTORS AS REQUIRED. A/V CABLES SHALL BE CONTINUOUS. RERUN A/V CONDUCTORS AS NEEDED.
- PROVIDE NEW LED A21, 1700 LUMEN, 4000K LAMPS, EQUAL TO GREEN CREATIVE 17A21GADM/840/R, FOR THE EXISTING CERAMIC BASE LIGHT SOCKETS IN THE SPACE. TROUBLESHOOT AND REPAIR LIGHTS AS NEEDED. FIELD VERIFY FOR QUANTITY.
- FURNISH AND INSTALL A 3-WAY SWITCH TO CONTROL THE EXISTING LIGHTS IN THE SPACE. MAKE MODIFICATIONS AS NEEDED TO EXISTING WIRING FOR A COMPLETE WORKING INSTALL.


GENERAL NOTES

- EC SHALL COORDINATE WITH ALL OTHER TRADES DURING DEMOLITION AND CONSTRUCTION TO FACILITATE TIMELY WORK.
- ALL AREAS ARE TO BE KEPT CLEAN AND CLEAR OF DEBRIS AT ALL TIMES.
- CONTRACTOR SHALL PATCH AND REPAIR ALL WALLS, CEILINGS ETC. TO MATCH EXISTING CONDITIONS. PENETRATIONS SHALL BE SEALED WITH FIRE RATED CAULK.
- ROUTE ALL CONDUIT IN A NEAT AND ORDERLY FASHION. ALL CONDUIT SHALL BE CONCEALED ABOVE CEILINGS OR IN WALLS OR FINISHED SPACES UNLESS OTHERWISE INDICATED ON THE PLANS.
- DEVICES SHOWN ON DEMOLITION SHEETS ARE GATHERED FROM AS-BUILT DRAWINGS AND FIELD INVESTIGATION. NOT ALL DEVICES ARE SHOWN. DEVICE PLACEMENT IS SCHEMATIC AND NOT EXACT. CONTRACTOR TO FIELD VERIFY FOR EXACT LOCATIONS AND COORDINATE WORK WITH ALL OTHER DEVICES, EQUIPMENT, CONDUIT, ETC. WHETHER OR NOT SHOWN TO COMPLETE PROJECT.
- CONTRACTOR TO COORDINATE WITH OWNER FOR ITEMS TO BE SALVAGED PRIOR TO DEMOLITION. CONTRACTOR RESPONSIBLE FOR DISPOSING OF ANY MATERIAL THAT THE OWNER DOES NOT WANT TO KEEP.
- CAP AND LABEL ALL EMPTY CONDUIT TO REMAIN.
- PROVIDE UPDATED TYPED PANEL SCHEDULES FOR PANELS AFFECTED BY THE SCOPE OF THIS WORK PER NEC 408.4.
- ALL NEW BREAKERS SHALL MATCH EXISTING AIC RATINGS OF ITS CORRESPONDING PANEL WHERE IT IS INSTALLED.



VAN BOERUM
& FRANK ASSOCIATES, INC.
CONSULTING ENGINEERS

330 South 300 East
Salt Lake City, UT 84111
801.530.3148 T
801.530.3150 F

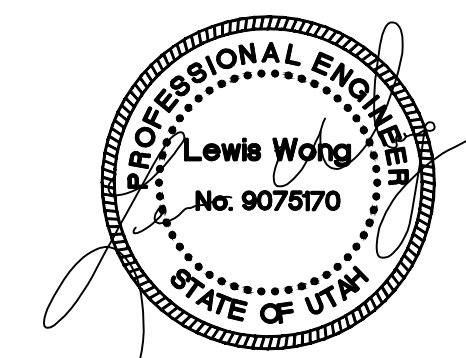

Original drawings remain the property of the Engineer and as such the Engineer retains total ownership and control. The design represented by these drawings are sold to the client for a one time use, unless otherwise agreed upon in writing by the Engineer.
• Van Boerum & Frank Assoc., 2014

Hobble Creek 1, 3, 13 & Springville UT Hobble Creek Stk.

SALT LAKE CITY, UTAH

REVISIONS

2/5/2018
ADDENDUM #2

VBFA PROJECT #: 17329
CHECKED BY: LW
DRAWN BY: EW
CURRENT/ISSUE DATE: JAN 2018

SHEET CONTENTS

DEMOLITION AND POWER PLAN

EP101

1

2

3

4


5

D

C

B

A

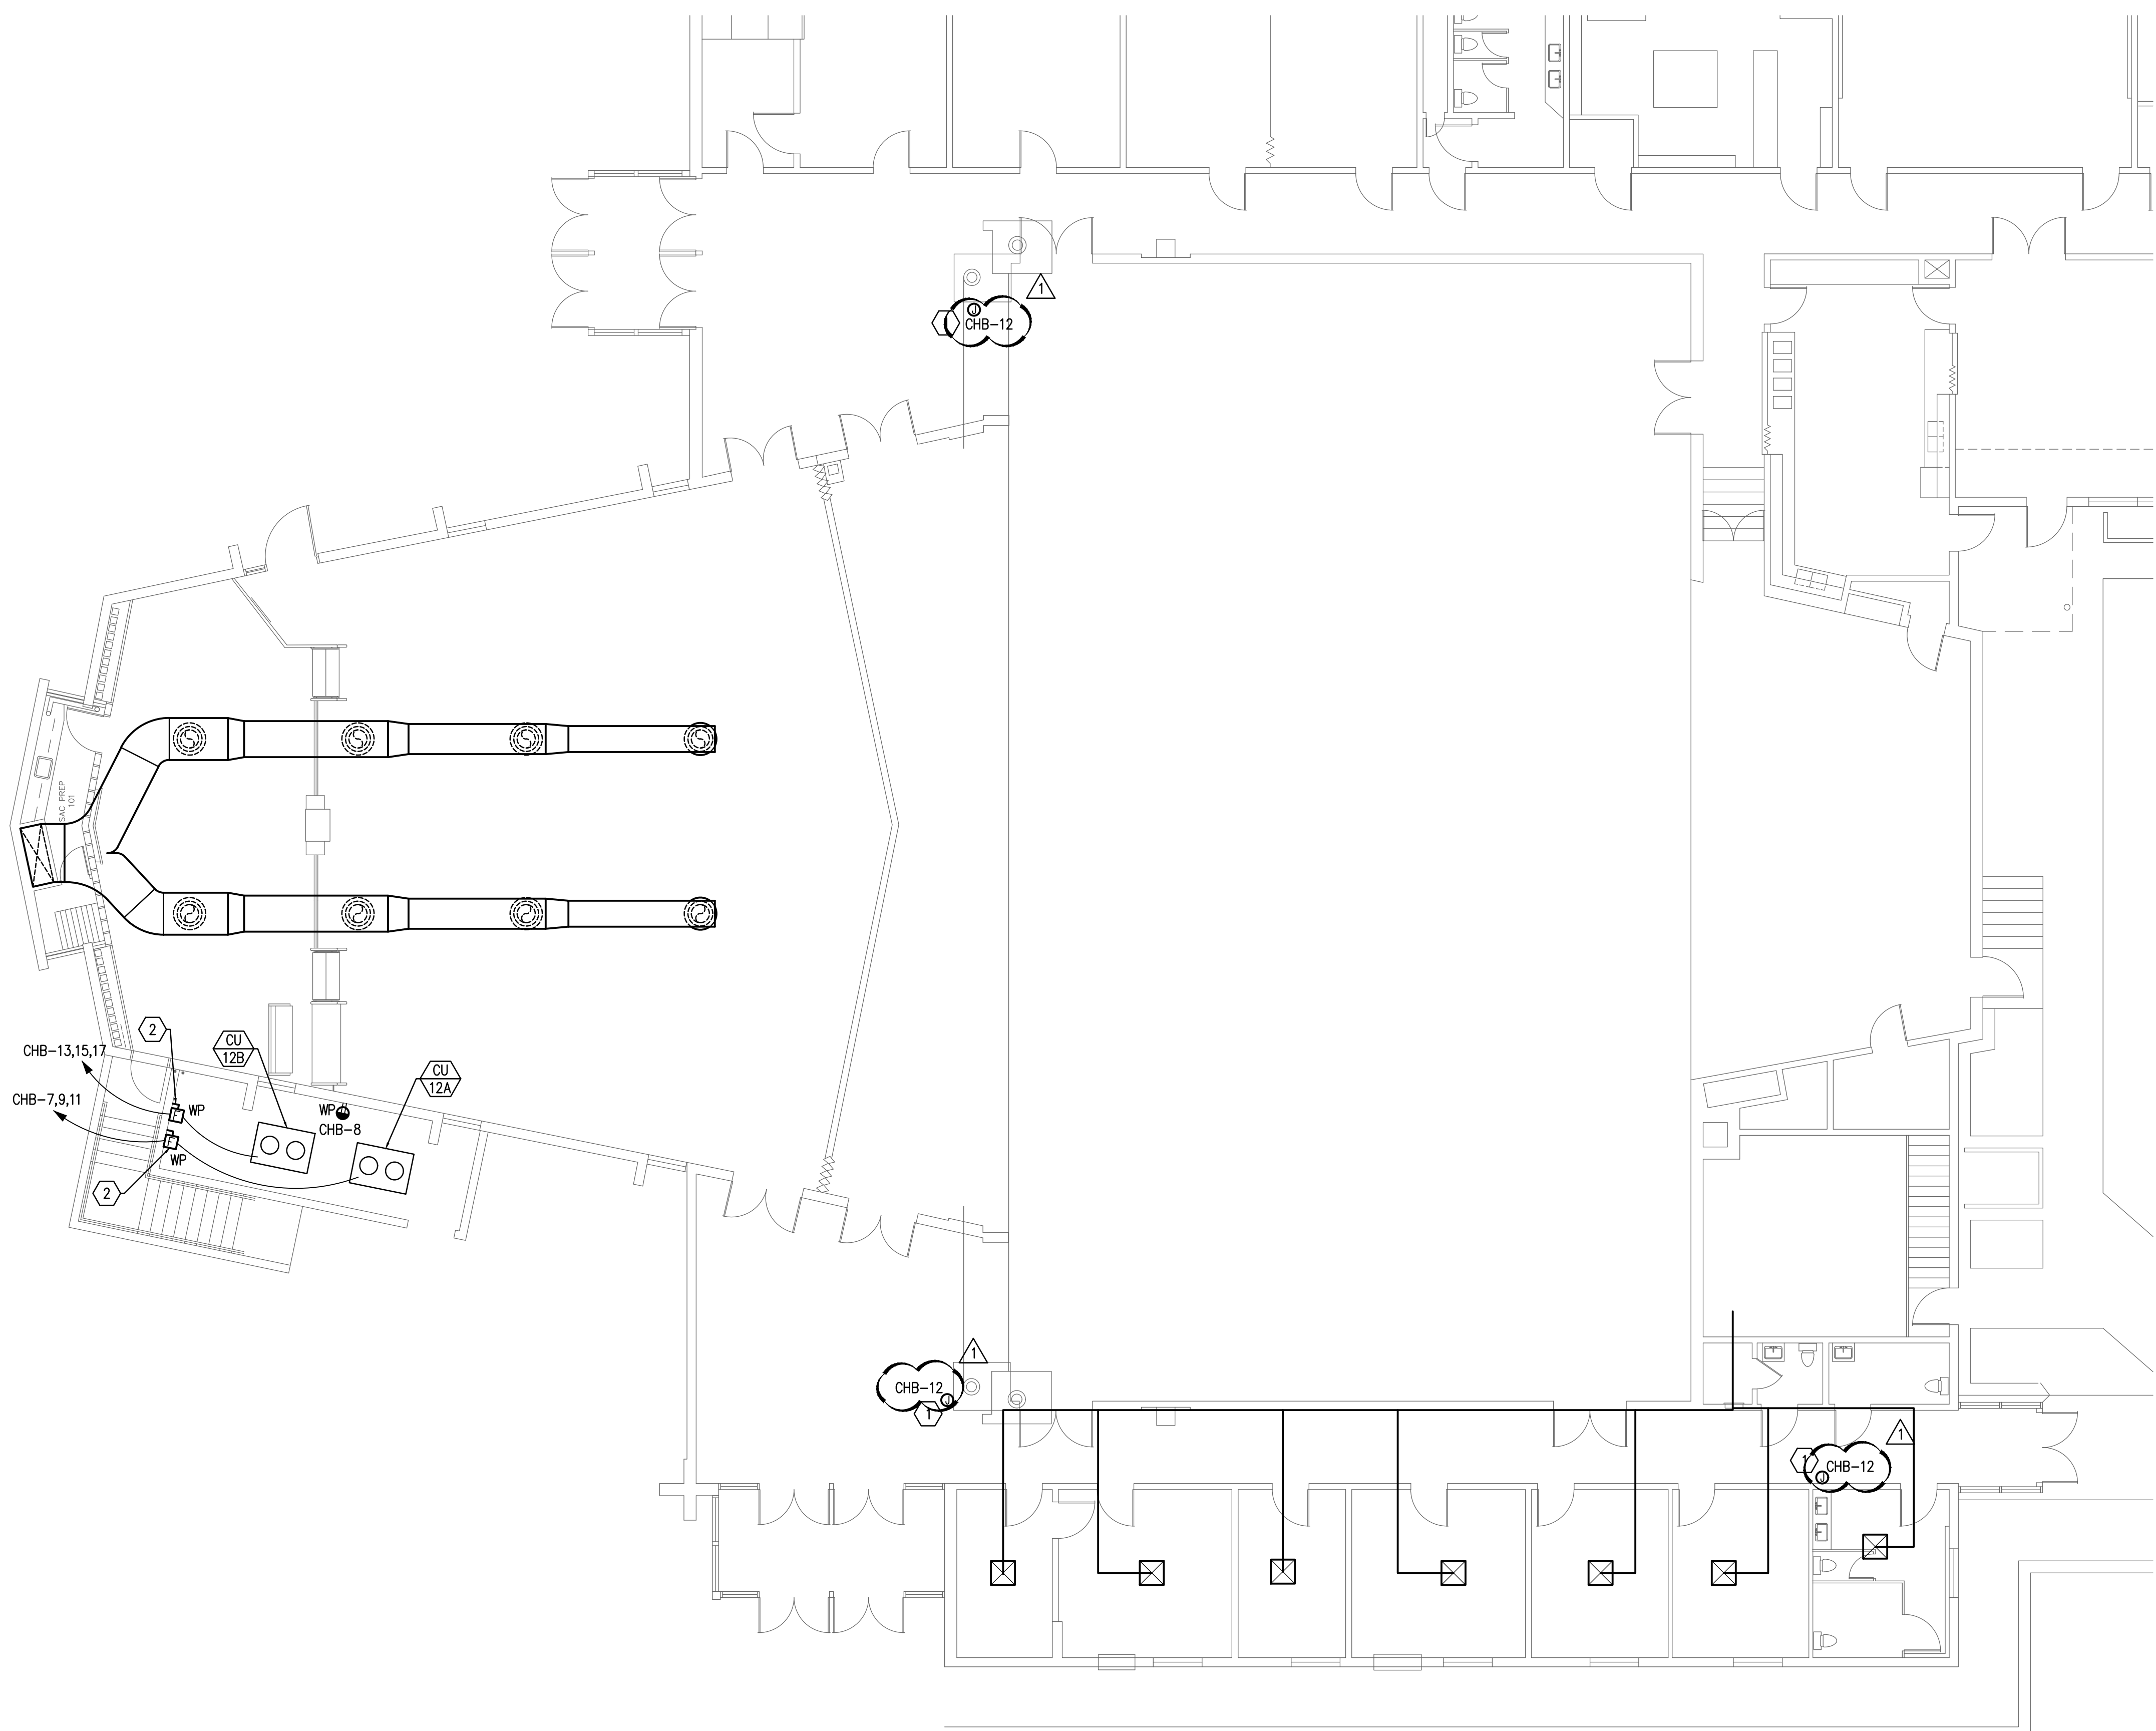

KEYED NOTES

1. PROVIDE 120V POWER IN CRAWL SPACE TO POWER ELECTRIC THERMOSTAT.
2. LOCATE FUSED DISCONNECTS TO MEET NEC CLEARANCE REQUIREMENTS.


GENERAL NOTES

- A. EC SHALL COORDINATE WITH ALL OTHER TRADES DURING DEMOLITION AND CONSTRUCTION TO FACILITATE TIMELY WORK.
- B. ALL AREAS ARE TO BE KEPT CLEAN AND CLEAR OF DEBRIS AT ALL TIMES.
- C. CONTRACTOR SHALL PATCH AND REPAIR ALL WALLS, CEILINGS ETC. TO MATCH EXISTING CONDITIONS. PENETRATIONS SHALL BE SEALED WITH FIRE RATED CAULK.
- D. ROUTE ALL CONDUIT IN A NEAT AND ORDERLY FASHION. ALL CONDUIT SHALL BE CONCEALED ABOVE CEILINGS OR IN WALLS OR FINISHED SPACES UNLESS OTHERWISE INDICATED ON THE PLANS.
- E. DEVICES SHOWN ON DEMOLITION SHEETS ARE GATHERED FROM AS-BUILT DRAWINGS AND FIELD INVESTIGATION. NOT ALL DEVICES ARE SHOWN. DEVICE PLACEMENT IS SCHEMATIC AND NOT EXACT. CONTRACTOR TO FIELD VERIFY FOR EXACT LOCATIONS AND COORDINATE WORK WITH ALL OTHER DEVICES, EQUIPMENT, CONDUIT, ETC. WHETHER OR NOT SHOWN TO COMPLETE PROJECT.
- F. CONTRACTOR TO COORDINATE WITH OWNER FOR ITEMS TO BE SALVAGED PRIOR TO DEMOLITION. CONTRACTOR RESPONSIBLE FOR DISPOSING OF ANY MATERIAL THAT THE OWNER DOES NOT WANT TO KEEP.
- G. CAP AND LABEL ALL EMPTY CONDUIT TO REMAIN.
- H. PROVIDE UPDATED TYPED PANEL SCHEDULES FOR PANELS AFFECTED BY THE SCOPE OF THIS WORK PER NEC 408.4.
- I. ALL NEW BREAKERS SHALL MATCH EXISTING AIC RATINGS OF ITS CORRESPONDING PANEL WHERE IT IS INSTALLED.



VAN BOERUM
& FRANK ASSOCIATES, INC.
CONSULTING ENGINEERS

330 South 300 East
Salt Lake City, UT 84111
801.530.3148 T
801.530.3150 F

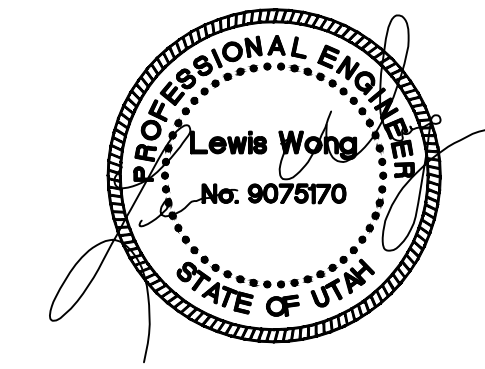

Original drawings remain the property of the Engineer and as such the Engineer retains total ownership and control. The design represented by these drawings are sold to the client for a one time use, unless otherwise agreed upon in writing by the Engineer.
• Van Boerum & Frank Assoc., 2014

Hobble Creek 1, 3, 13 & Springville UT Hobbie Creek Stk.



SALT LAKE CITY, UTAH

REVISIONS	
▲	2/5/2018 ADDENDUM #2

VBFA PROJECT #:	17329
CHECKED BY:	LW
DRAWN BY:	EW
CURRENT/ISSUE DATE:	JAN 2018

SHEET CONTENTS
CHAPEL POWER PLAN

EP102

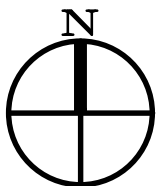

ELECTRICAL PLAN
 SCALE: 1/8" = 1'-0"
